


PLAN
100'
0 200'
FEET

MAGNETIC DECLINATION: 13° 7' 16" E
ANNUAL RATE CHANGE: 7.7" W
SOURCE: NOAA
DATE: DECEMBER 5, 2013

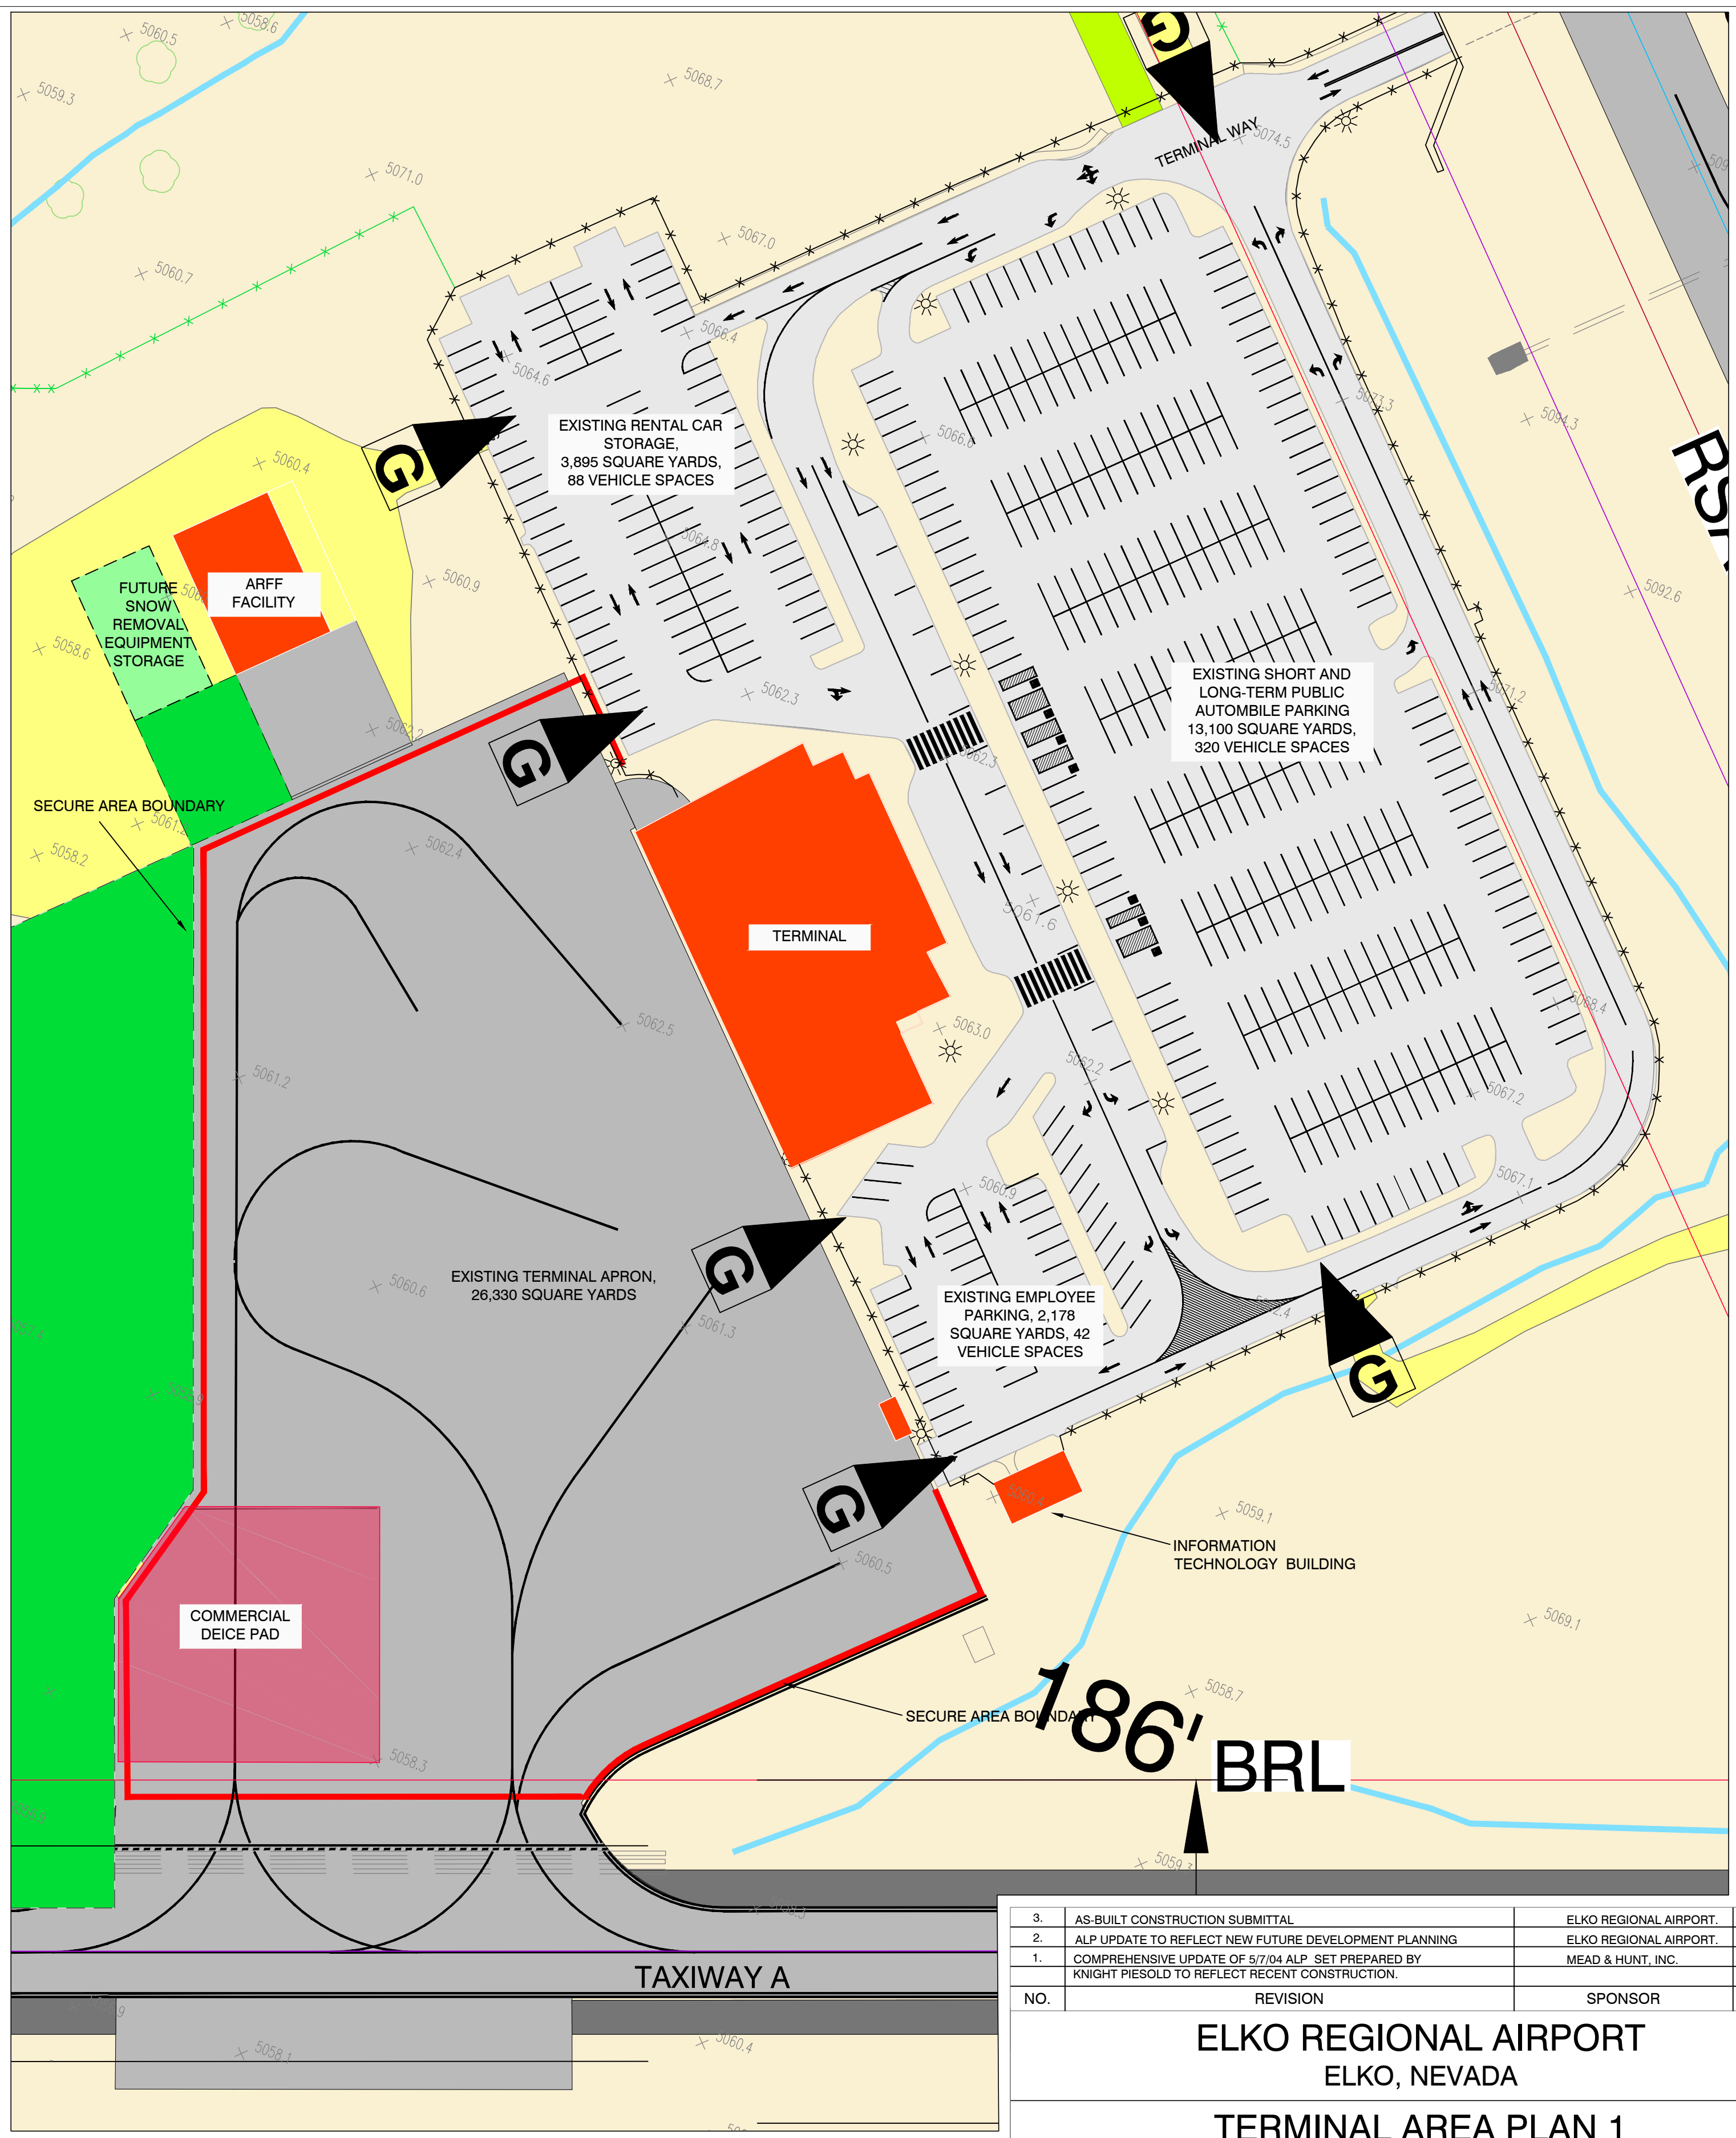

PLAN
60'
0 120'
FEET

MAGNETIC DECLINATION: 13° 7' 16" E
ANNUAL RATE CHANGE: 7.7" W
SOURCE: NOAA
DATE: DECEMBER 5, 2013

DRAWING LEGEND			
	VISUAL APPROACH SLOPE INDICATOR (VASI), (E)		FENCING
	VISUAL APPROACH SLOPE INDICATOR (VASI), (F)		GATE
	RUNWAY END IDENTIFIER LIGHTS (REILS), (E)		OBSTACLE FREE ZONE EXIST/FUTURE
	RUNWAY END IDENTIFIER LIGHTS (REILS), (F)		OBJECT FREE AREA EXIST/FUTURE
	AIRPORT ROTATING BEACON		RUNWAY PROTECTION ZONE EXIST/FUTURE
	RUNWAY LIGHTS		RUNWAY SAFETY AREA EXIST/FUTURE
	AIRCRAFT TIEDOWN (E)		BUILDING RESTRICTION LINE (BRL)
	OVERHEAD UTILITY POLE (E)		CLEARWAY
	BILLBOARD SIGN (E)		CRITICAL AREAS
	OVERHEAD APRON/STREET LIGHT (E)		TERRAIN OBSTRUCTION TO FAR PART 77 SURFACE (APPROXIMATE LOCATION)
	AUTOMATED SURFACE OBSERVING SYSTEM (E)		EXISTING PROPERTY
	SUPPLEMENTAL WIND CONE		PROPERTIES TO BE ACQUIRED IN FEE (F)
	SECTION CORNER		AVIGATION EASEMENTS TO BE ACQUIRED (F)
	BUILDINGS, EXISTING / FUTURE		WINDCONE & SEGMENTED CIRCLE
	AIRFIELD PAVEMENT / MARKINGS (E)		AIRFIELD PAVEMENT (F)
	PUBLIC ROAD/AUTO PARKING (E)		HIGHWAY (FEDERAL, STATE, MUNICIPAL)
	ROAD (ACCESS/LIGHT DUTY)		VEHICLE SERVICE/PERIMETER ROAD (E)
	VEHICLE SERVICE/PERIMETER ROAD (F)		ROAD (UNIMPROVED)
	VEHICLE TUNNEL (E)		VEHICLE TUNNEL EXTENSION (F)
	BENCHMARK/MONUMENT		WATERWAY/EDGE OF WATER/DRAINAGE
	CULVERT/DRAINAGE STRUCTURE (E)		TREE/BUSH/UNDERGROWTH
	EXISTING GROUND SURFACE		SPOT ELEVATION, FEET NAVD 88

REFERENCE:
TOPOGRAPHIC MAPPING PROVIDED BY AERO-GRAHICS, INC. DATED:
04/23/03 RECEIVED BY KNIGHT PIESOLD ON 04/25/03.

NO.	REVISION	SPONSOR	DATE
3.	AS-BUILT CONSTRUCTION SUBMITTAL	ELKO REGIONAL AIRPORT.	10/2014
2.	ALP UPDATE TO REFLECT NEW FUTURE DEVELOPMENT PLANNING	ELKO REGIONAL AIRPORT.	11/2013
1.	COMPREHENSIVE UPDATE OF 5/7/04 ALP SET PREPARED BY KNIGHT PIESOLD TO REFLECT RECENT CONSTRUCTION.	MEAD & HUNT, INC.	10/2010

ELKO REGIONAL AIRPORT
ELKO, NEVADA

TERMINAL AREA PLAN 1

	Elko Regional Airport 975 Terminal Way Elko, NV 89801 TEL (775) 777-7190 FAX (775) 777-7193		
DESIGN: VT	DRAWN: MG	DATE: OCTOBER 2014	SHEET 3 OF 13

The preparation of these documents was financed in part through a planning grant from the Federal Aviation Administration as provided under Section 505 of the Airport and Airway Improvement Act of 1982, as amended. The contents do not necessarily reflect the official views or policy of the FAA. Acceptance of these documents by the FAA does not in any way constitute a commitment on the part of the United States to participate in any development depicted herein nor does it indicate that the proposed development is environmentally acceptable in accordance with appropriate public laws.